


275 and 277 E/ Historic Col. River Hwy  
Troutdale Oregon  
AS BUILT DRAWING  
(Scale 1/8" equals 1' 0")

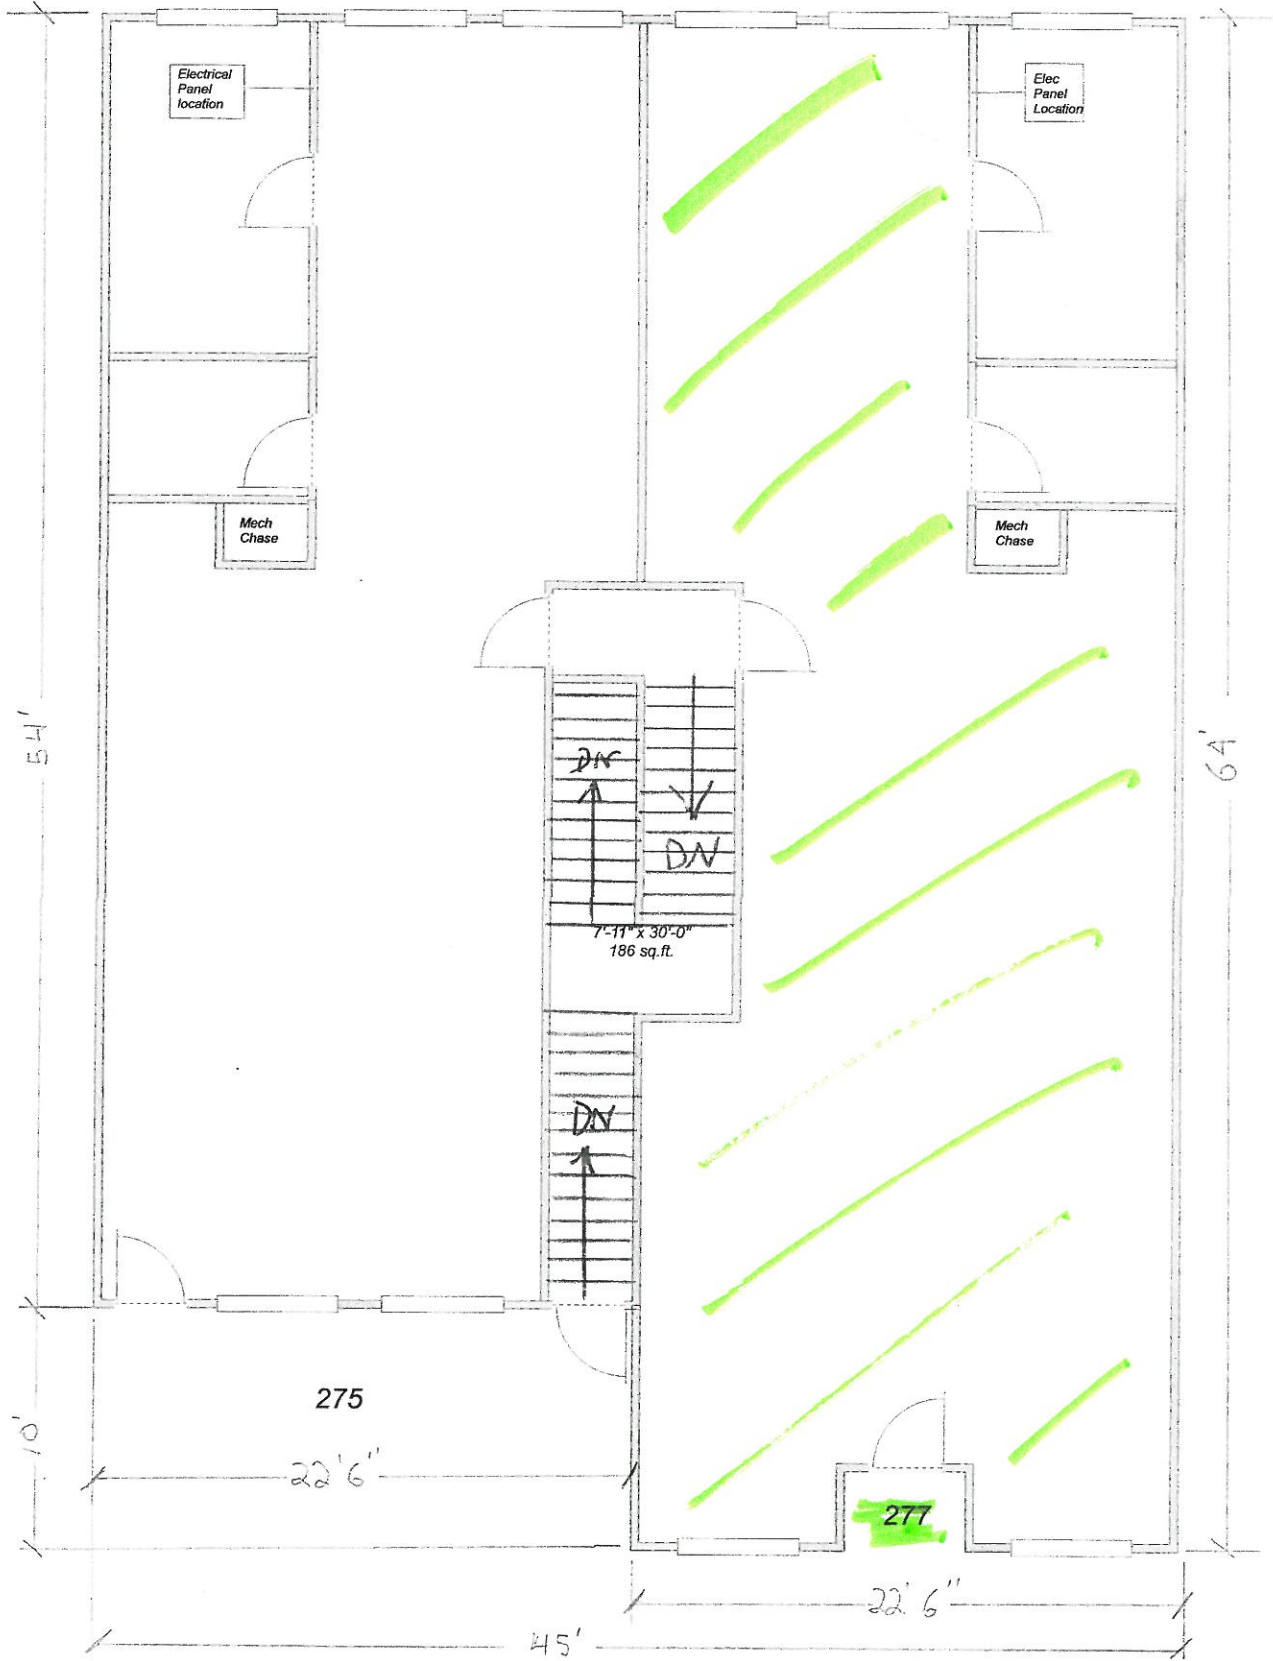

AREA: 2632<sup>D</sup> FT

PLAN  
1

9/17/2011